

A

B


C

D

E

MATCHLINE N.275.370 (N 6343594.50 UTM)
CONT. ON DWG. SNRS-01-01-P-PP-00003-1


LEASE AND TREE CLEARING LIMITS N.275.390

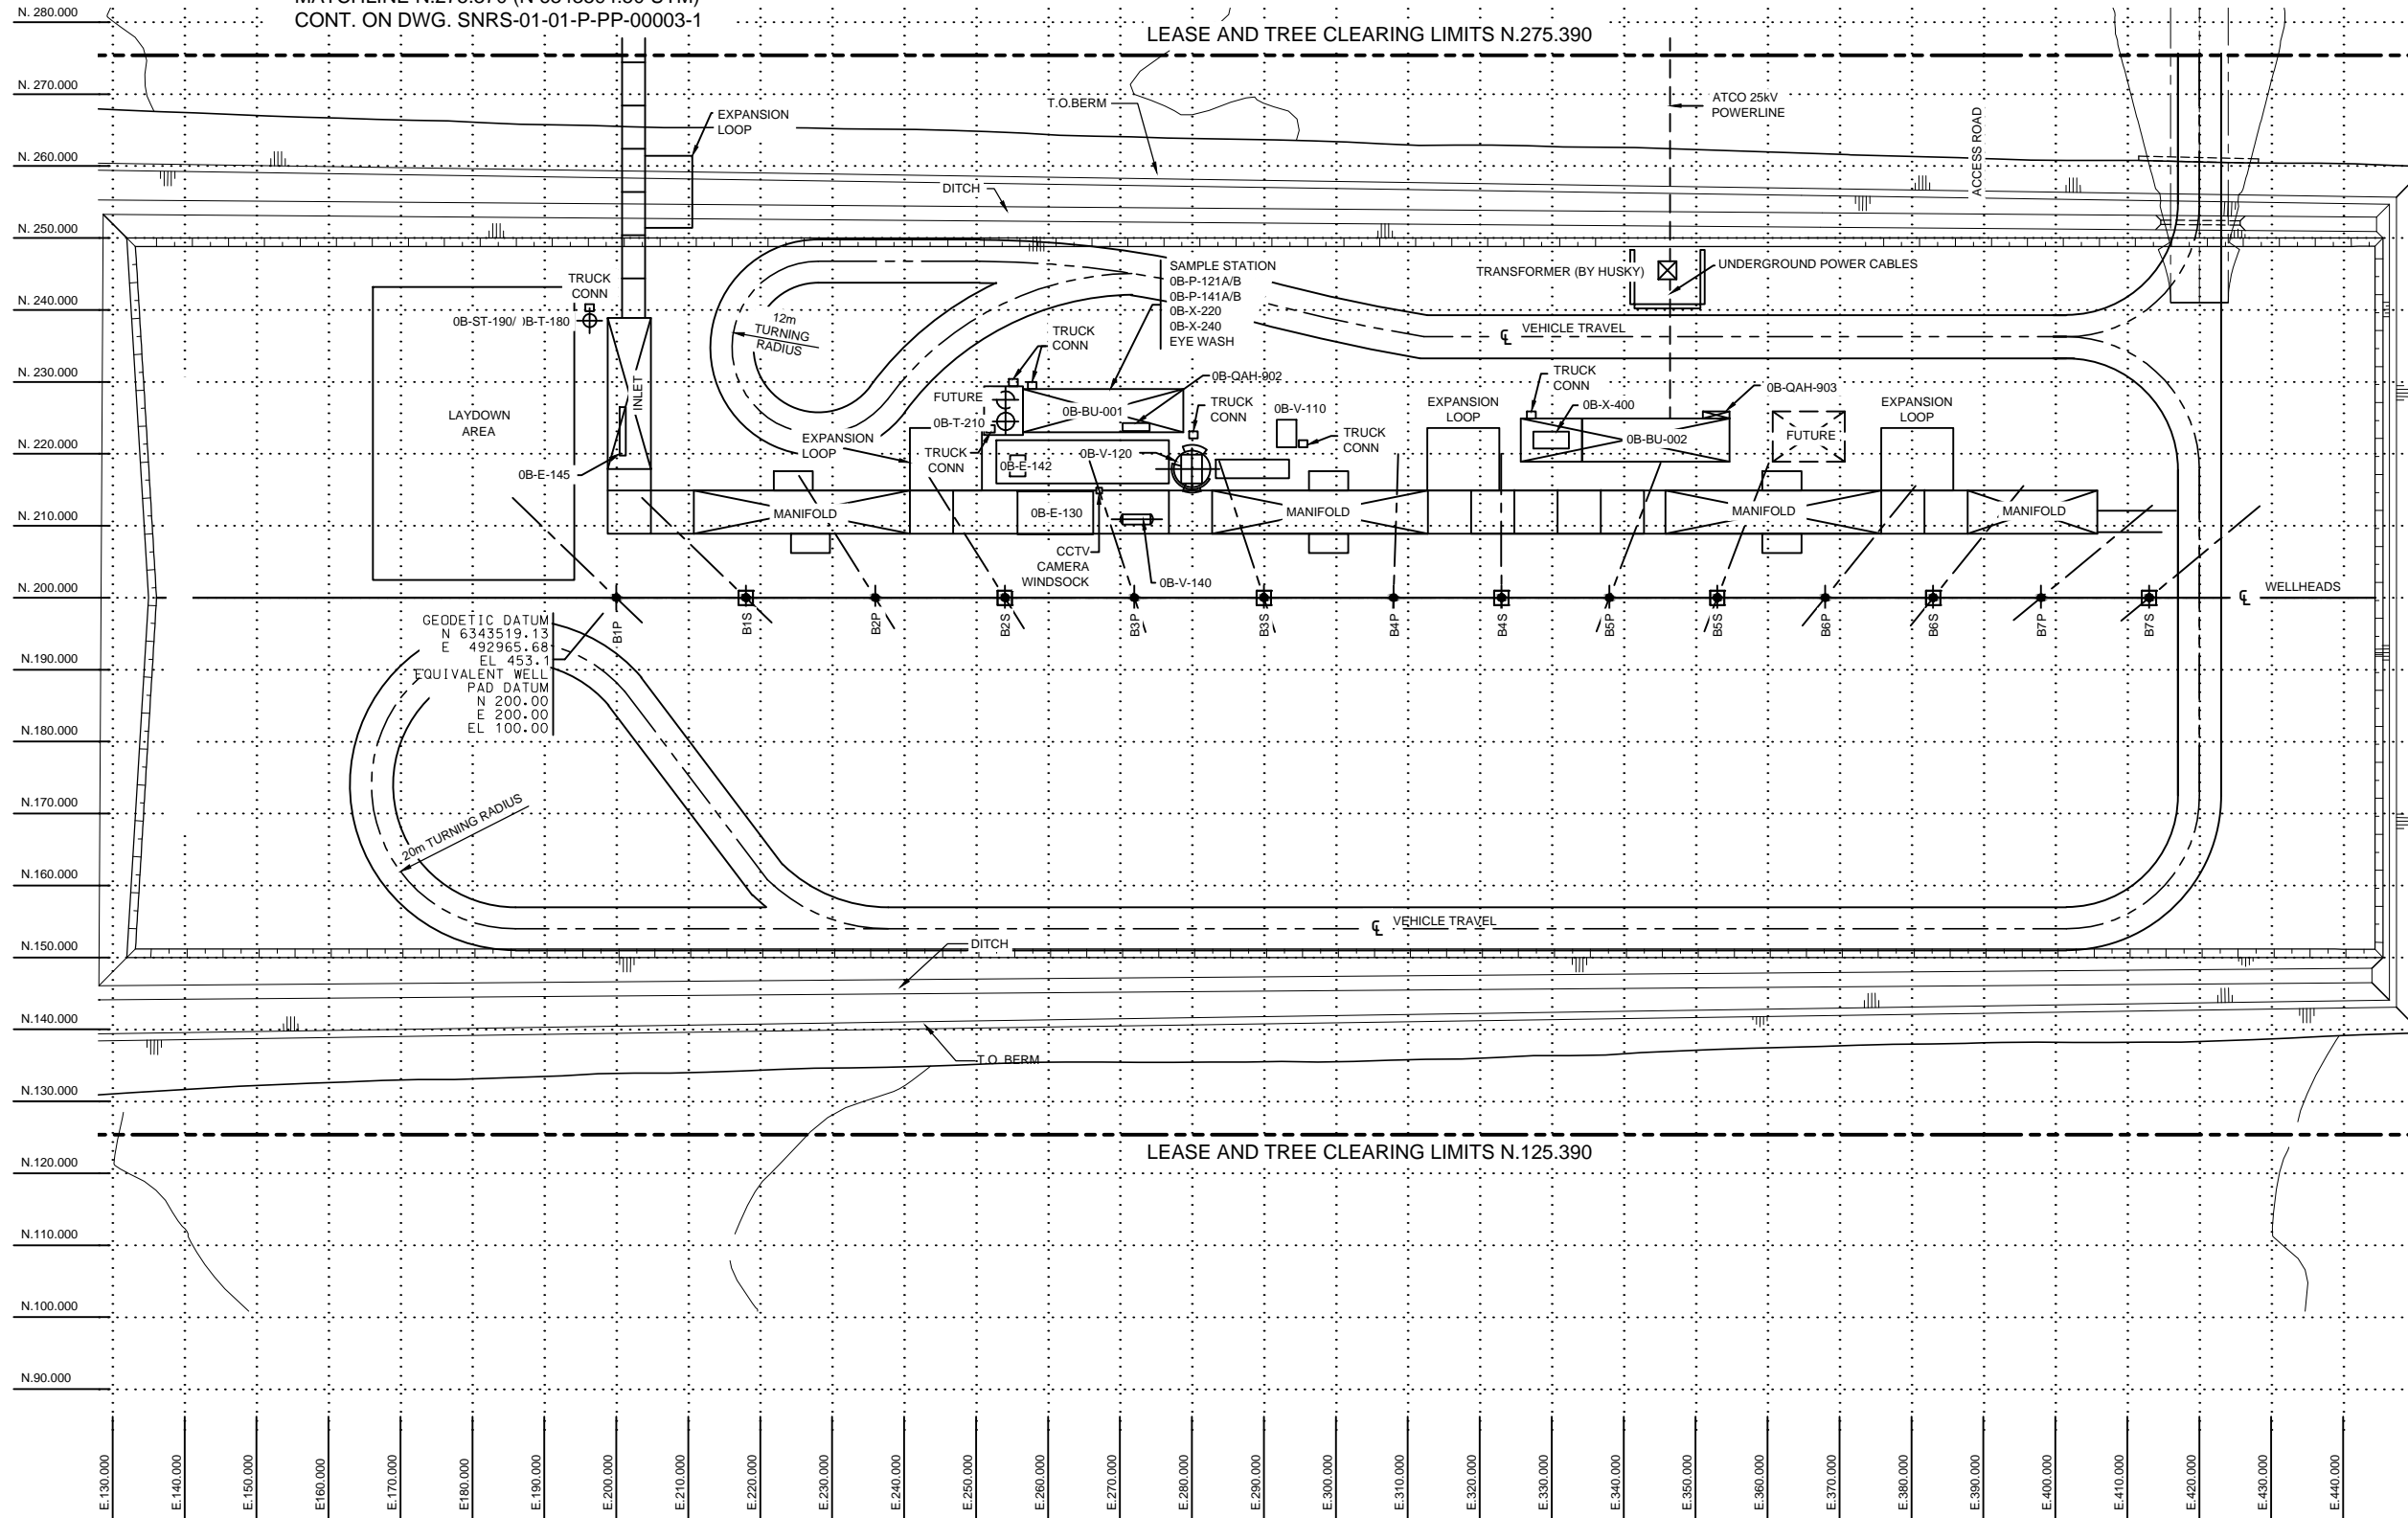

NOTES

EQUIPMENT TABLE	
EQUIPMENT NO.	EQUIPMENT NAME
0B-BN-231	CORR. INIHB. TOTE (PACKAGE 0B-X-240)
0B-BU-001	PUMP BUILDING
0B-BU-002	MCC/DCS BUILDING
0B-E-130	PRODUCED GAS CONDENSER
0B-E-142	SEAL FLUSH CONDENSATE COOLER
0B-E-145	LIFT GAS HEAT EXCHANGER
0B-P-121A/B	EMULSION PUMPS
0B-P-141A/B	CONDENSATE PUMPS
0B-P-221A/B	DEMULSIFIER PUMPS (PACKAGE 0B-X-220)
0B-P-241A/B	CORR. INHIB. INJ. PUMPS (PACKAGE 0B-X-240)
0B-QAH-902	PUMP BUILDING MAKE-UP AIR UNIT
0B-QAH-903	MCC/DCS/BUILDING AIR-HANDLING UNIT
0B-ST-190	VENT STACK FOR POP TANK
0B-T-180	POP TANK
0B-T-210	DEMULSIFIER TANK
0B-V-110	TEST SEPARATOR
0B-V-120	GROUP SEPARATOR
0B-V-140	PRODUCED GAS SEPARATOR
0B-X-220	DEMULSIFIER PUMP PACKAGE
0B-X-240	CORROSION INHIBITOR INJECTION PACKAGE
0B-X-400	INSTRUMENT AIR PACKAGE

LEGEND	
	INJECTION WELL
	PRODUCTION WELL

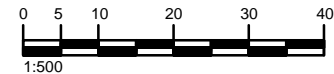

ENGINEERING COMPANY PERMIT STAMP REGISTERED PROFESSIONAL ENGINEER STAMP

PERMIT TO PRACTICE
WorleyParsons Canada Services Ltd.
PERMIT NUMBER: P 0725
The Association of Professional Engineers,
Geologists and Geophysicists of Alberta

6		
5		
4		
3		
2	SNRS-01-0B-P-LP-00001-1	EQUIPMENT LOCATION PLAN
1	SNRS-01-0B-P-KP-00001-1	MODULE KEY PLAN
REF	DRAWING NUMBER	DRAWING TITLE
REFERENCE DRAWINGS		
3	2015-01-14	ISSUED FOR AS-BUILT (NO CHANGE)
1B	2012-08-27	RE-ISSUED FOR CONSTRUCTION
1A	12.01.06	ISSUED FOR CONSTRUCTION
REV	DATE	DESCRIPTION

REVISION HISTORY

Husky Oil Operations Limited



WorleyParsons
resources & energy

SUNRISE OIL SANDS PROJECT
FIELD FACILITIES

TITLE		PLOT PLAN WELL PAD 'B'
SURFACE LOCATION		13-08-95-07 W4M
ALTERNATE DWG NUMBER		REV NO
HUSKY DWG NUMBER	SNRS-01-0B-P-PP-00001-1	3
VENDOR DWG NUMBER		SCALE
AMU/FLOC NUMBER		1:500
DCN NO	PROJECT NO 200182000	