


AB BT 0089133						
WELL PAD B13P INFLL WELLS						
WELL NAME	UWI	LSD	LC/OPER	DETAIL	STATUS	FUEL
B9EP	111/16-32-064-04W4/00	01-32-064-04W4	HUSKY	OIL 2F	PRODUCING	-
						FC-213H FC-213G

AB BT 0089133						
WELL PAD B14P INFLL WELLS						
WELL NAME	UWI	LSD	LC/OPER	DETAIL	STATUS	FUEL
B10EP	113/16-32-064-04W4/00	01-32-064-04W4	HUSKY	OIL 2F	PRODUCING	-
						FC-214H FC-214G

AB BT 0089133						
WELL PAD B15P INFLL WELLS						
WELL NAME	UWI	LSD	LC/OPER	DETAIL	STATUS	FUEL
B11EP	115/16-32-064-04W4/00	01-32-064-04W4	HUSKY	OIL 2F	PRODUCING	-
						FC-215H FC-215G

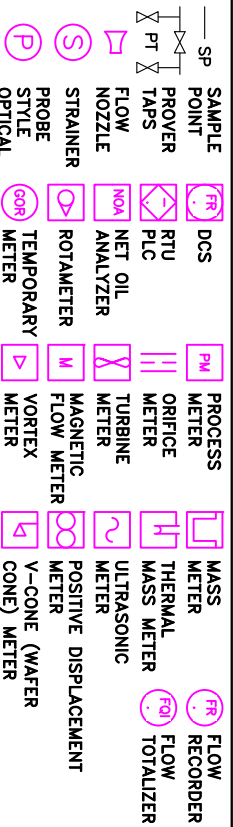

REF. DWG. NO.	AREA OVERVIEW	REFERENCE DRAWING DESCRIPTION	NO.	REVISION HISTORY	REV. AUTHOR	REV. DATE	ISSUED FOR
MS-0000-01	PLANT DRAWING		1	UPONED PER MARK UPS SUPPLIED BY TUN. OIL	WDA	2012/02/01	AS BUILT
MS-0001-01 & 02	PLANT DRAWING		2	UPONED PER MARK-UPS FROM ALTYSON HADLAND	DMM	2013/06/07	AS BUILT
MS-0002-01,02,04&05	GATHERING SYSTEM		3	UPONED PER MARK UPS FROM ALTYSON HADLAND	SK	2014/06/20	AS BUILT
MS-0007-01	STEAM INJECTION SYSTEM		4	UPONED FROM MARK UPS SUPPLIED BY ALTYSON HADLAND	BMH	2015/02/24	AS BUILT
MS-0010-01	LOCIT UNIT		5	NO UPDATES FOR THIS REVISION FROM ALTYSON HADLAND	BMH	2015/10/29	AS BUILT
			6	UPONED FROM MARK UPS FROM ALTYSON HADLAND	BMH	2016/02/24	AS BUILT
			7				

CURRENT REVISION				
NO	NO UPDATES FOR THIS REVISION FROM ALTYSON HADLAND	ISSUED FOR	AS BUILT	
7		DOC DATE	2016/08/12	
<b>Husky Oil Operations Limited</b>				
TUCKER CENTRAL PLANT 12-28-064-04W4				
GATHERING SYSTEM-- B PADS				
MEASUREMENT SCHEMATIC				
			SCALE	NTS
			ALTERNATE IDENTIFIER	
			SHEET NO.	12-28-064-04W4
			DOCUMENT NUMBER	MS-0002-03

22206