



MATCHLINE N. 1180.500

CONTINUED ON DRAWING SNRS-01-96-P-PP-00006-1

PLANT  
SCALE  
1:1000

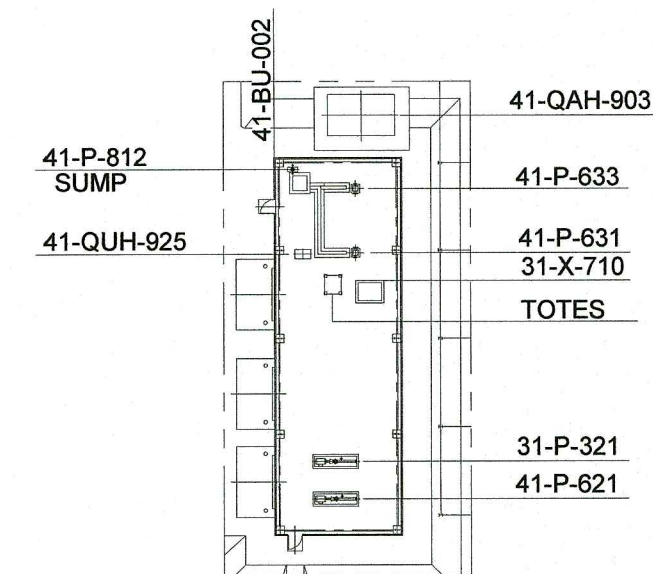


DETAIL  
41-BU-002  
SCALE  
1:500


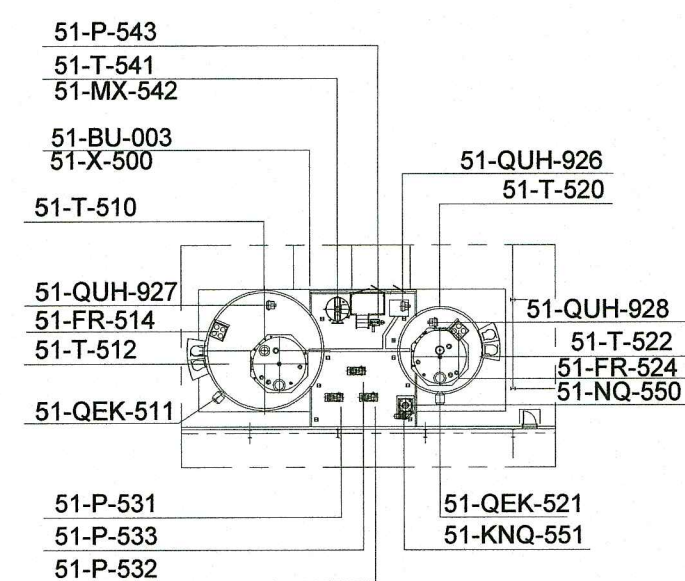


DETAIL  
51-BU-003/51-X-500  
SCALE  
1:500

- NOTES:
- ALL COORDINATES AND ELEVATIONS ARE IN METERS.
  - FOR ROAD DETAILS, REFER TO CIVIL DRAWINGS:  
SNRS-01-96-CV-PB-00003-1,  
SNRS-01-96-CV-PB-00004-1,  
SNRS-01-96-CV-PB-00005-1,  
SNRS-01-96-CV-PB-00006-1.

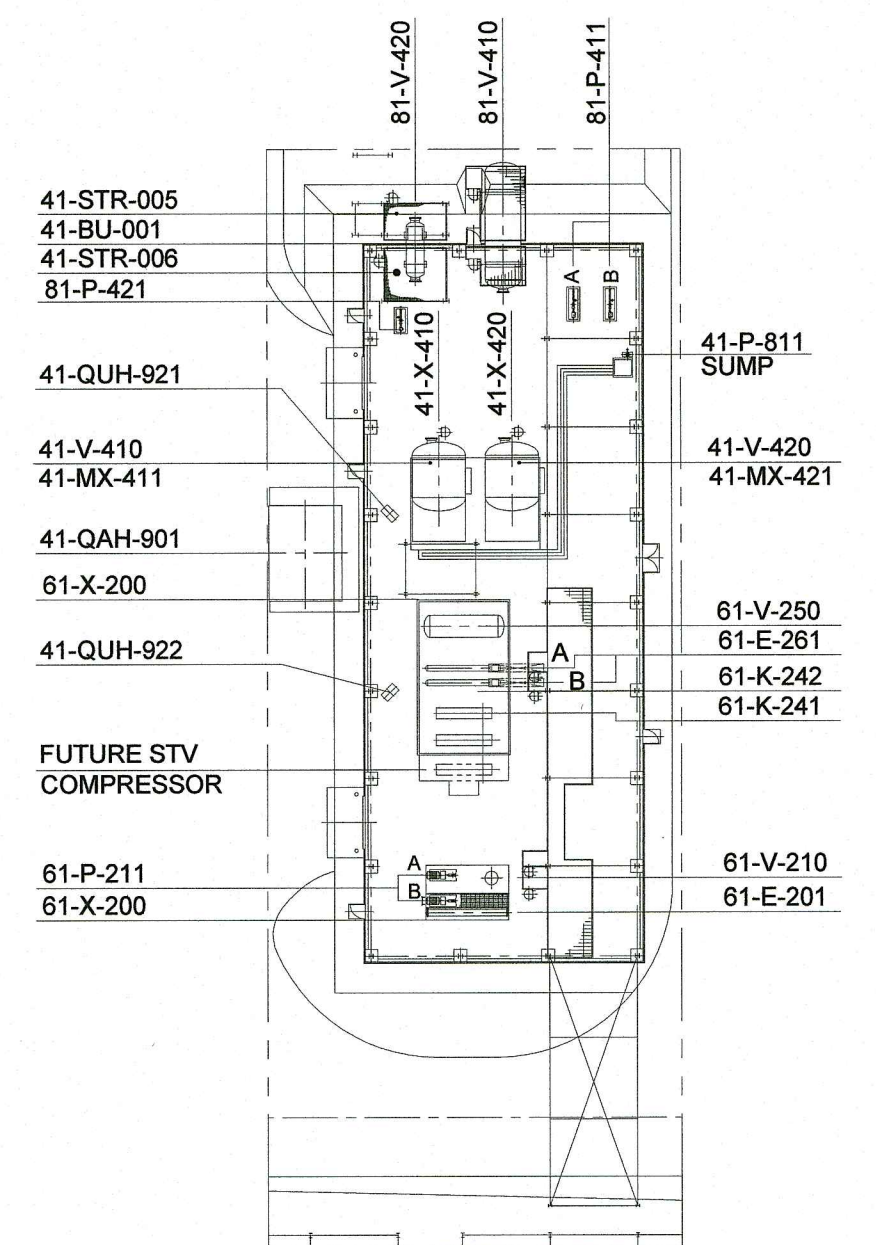


DETAIL  
41-BU-001  
SCALE  
1:500

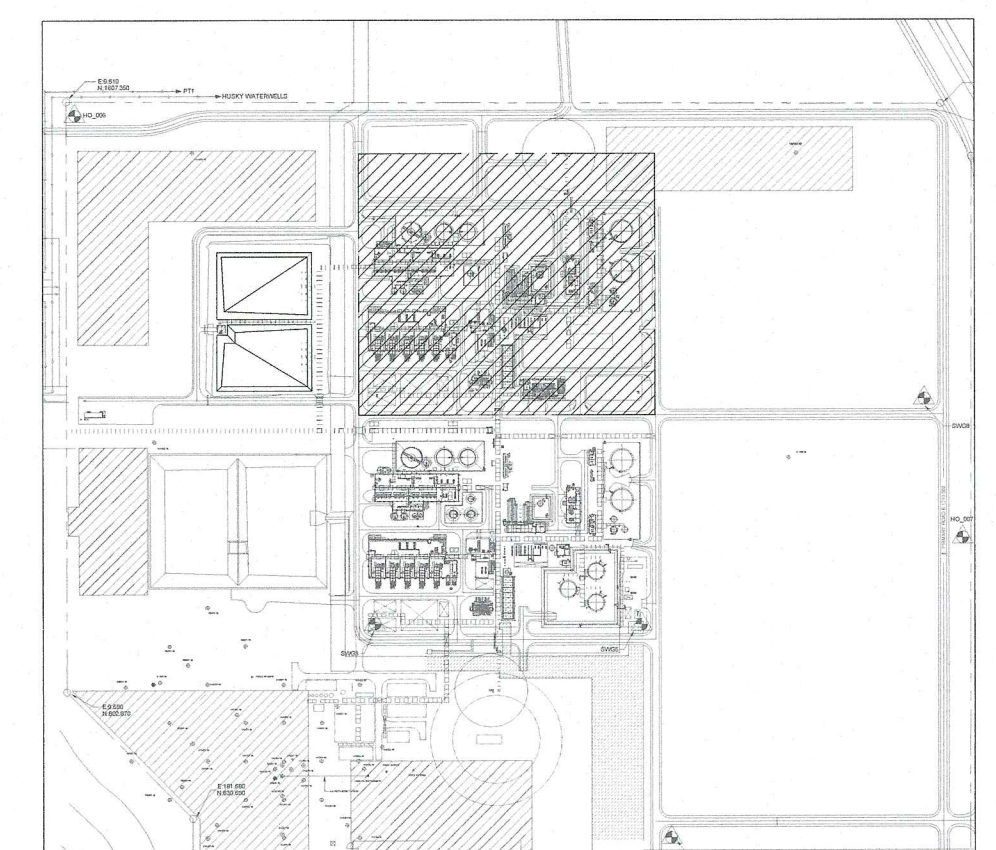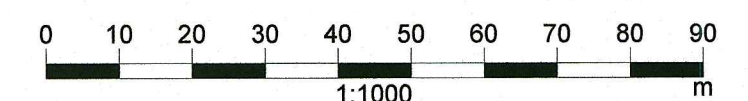

AREA KEY PLAN  
SCALE 1:10000



snamprogetti canada

SPCAN JOB NO H03747				PROJECT NO SR-071			
NO		CURRENT REVISION		ISSUED FOR		AS BUILT	
6		ISSUED FOR AS BUILT		DOC DATE		15-07-30	
				DOC AUTHOR		X.SHEN	
		<b>Husky Oil Operations Limited</b>				SCALE 1:1000	
SUNRISE OIL SANDS PROJECT CENTRAL PROCESSING FACILITIES PLOT PLAN PLANT 1B				ALTERNATE IDENTIFIER 98-GB-B-62007			
				SURFACE LSP 4-15-95-07 W4M			
				DOCUMENT IDENTIFIER SNRS-01-96-P-PP-00007-1			

ENGINEERING COMPANY PERMIT STAMP		REGISTERED PROFESSIONAL ENGINEER STAMP				6	15-07-30	ISSUED FOR AS BUILT	AS BUILT	XS				
						1F	13-03-04	RE-ISSUED FOR CONSTRUCTION	CONSTRUCTION	CC	MB	AS	EA	
						1E	12-11-08	RE-ISSUED FOR CONSTRUCTION	CONSTRUCTION	VS	MB	AS	EA	
						1D	12-04-16	ISSUED FOR CONSTRUCTION	CONSTRUCTION	VS	MB	AS	LF	
		SNRS-01-61-P-LP-00001-1		EQUIPMENT LOCATION PLAN SULPHUR RECOVERY UNIT PLANT 1B		1D	12-04-16	ISSUED FOR CONSTRUCTION	CONSTRUCTION	VS	MB	AS	LF	
		SNRS-01-96-P-PP-00007-2		PLOT PLAN - EQUIPMENT LIST PLANT 1B		1C	11-10-07	RE-ISSUED FOR REVIEW	REVIEW	AJ	MB	MME	ASA	
		SNRS-01-96-P-PP-00006-1		PLOT PLAN PLANT 1A		1B	11-03-28	RE-ISSUED FOR REVIEW	REVIEW	AJ	MB	RCA	ASA	
		SNRS-01-96-P-SI-00002-1		SITE PLAN PHASE 1A, 1B, 2A & 2B		1A	11-01-15	ISSUED FOR REVIEW	REVIEW	PF	SV	RCA	ASA	
		REF DWG NO		REFERENCE DRAWING DESCRIPTION		NO	REV DATE	REVISION HISTORY	ISSUED FOR	BY	CHK	ENG	API	