





MATCHLINE N. 1180.500 € ROAD

CONTINUED ON DRAWING SNRS-01-96-P-PP-00007-1

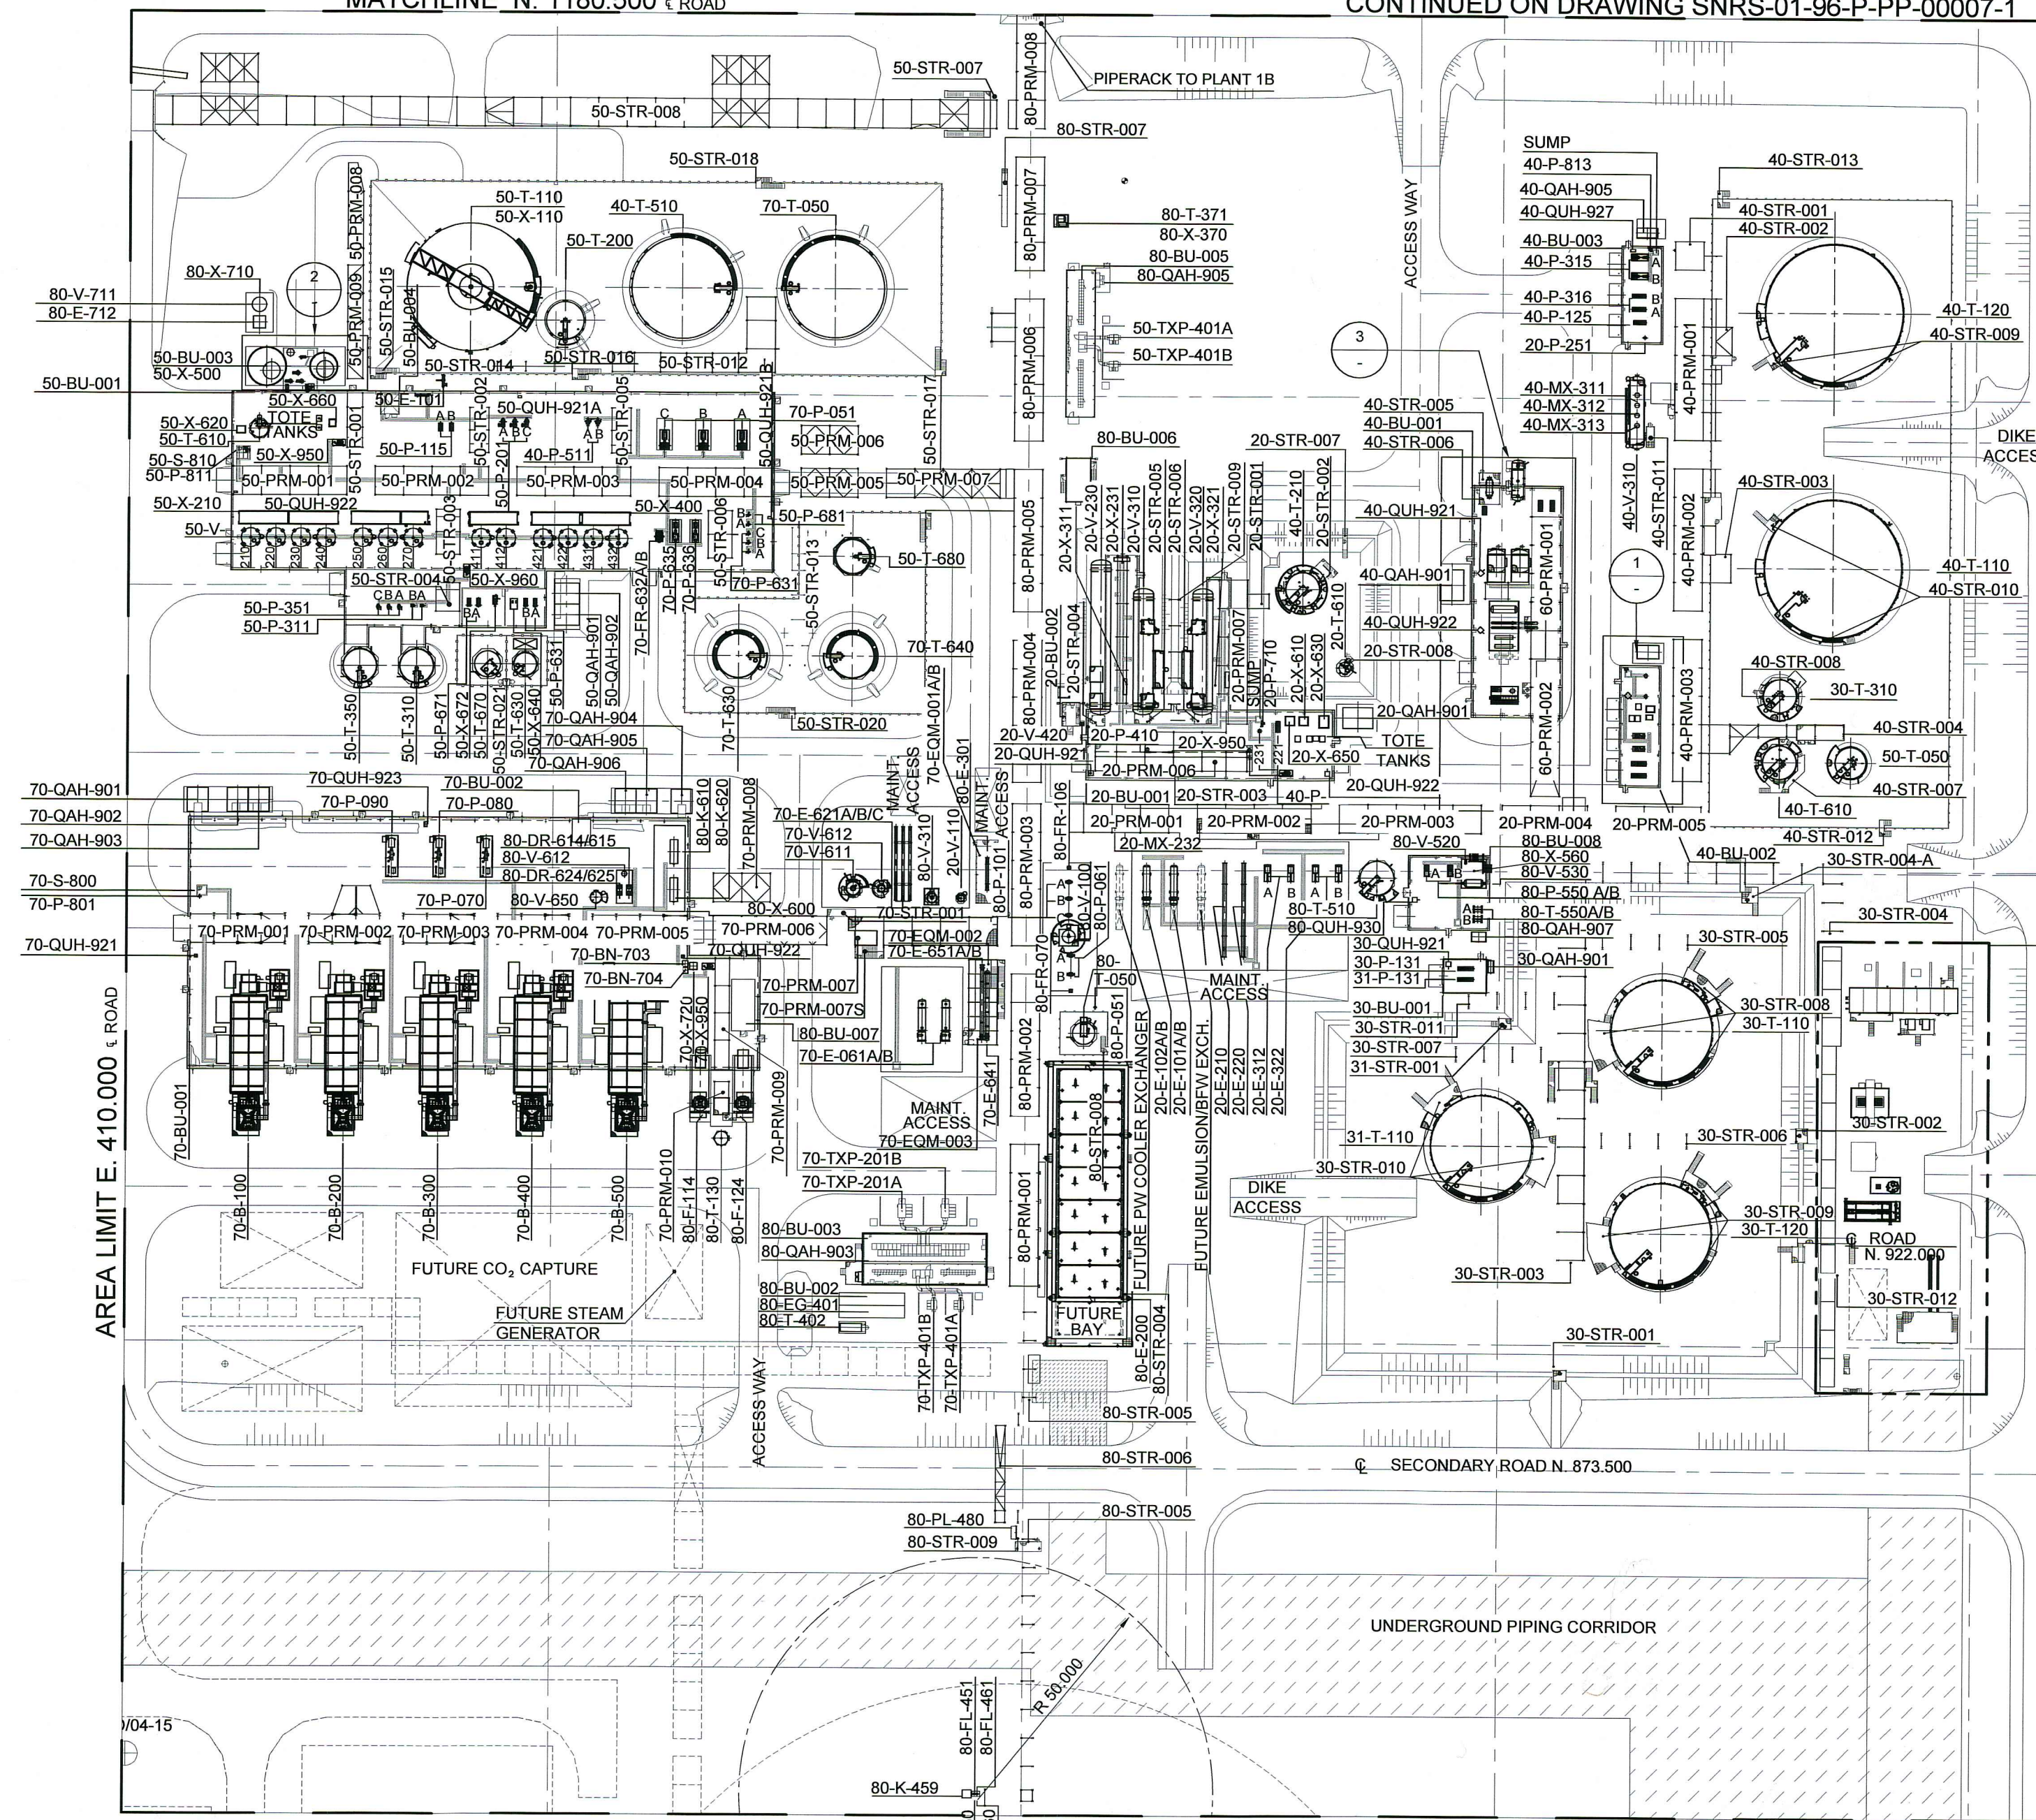


AREA LIMIT N. 800.000


PLANT 1A
SCALE 1:1000

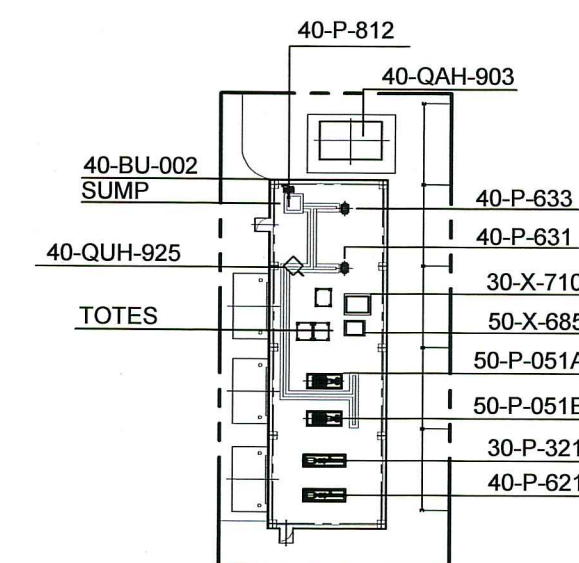

DETAIL
40-BU-002 SCALE 1:500

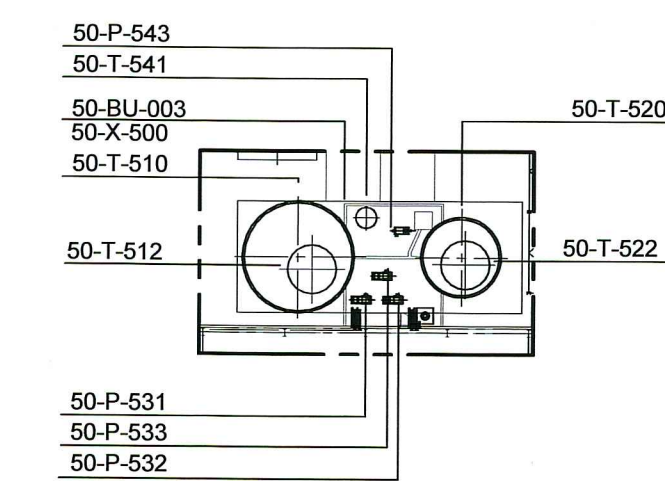


DETAIL
50-BU-003/50-X-500 SCALE 1:500

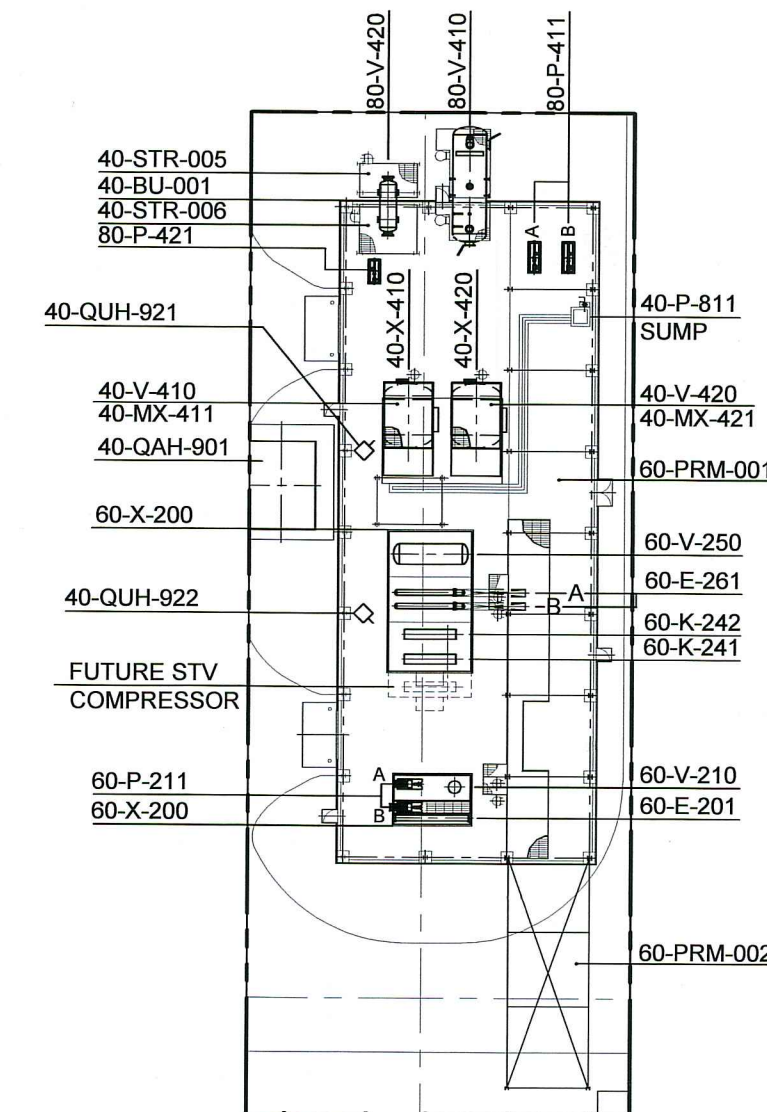


DETAIL
40-BU-001 SCALE 1:500

NOTES

1. ALL COORDINATES ARE IN METERS.
2. DETAIL 4 (40-BU-004) IS SHOWN IN SLUDGE POND AREA.

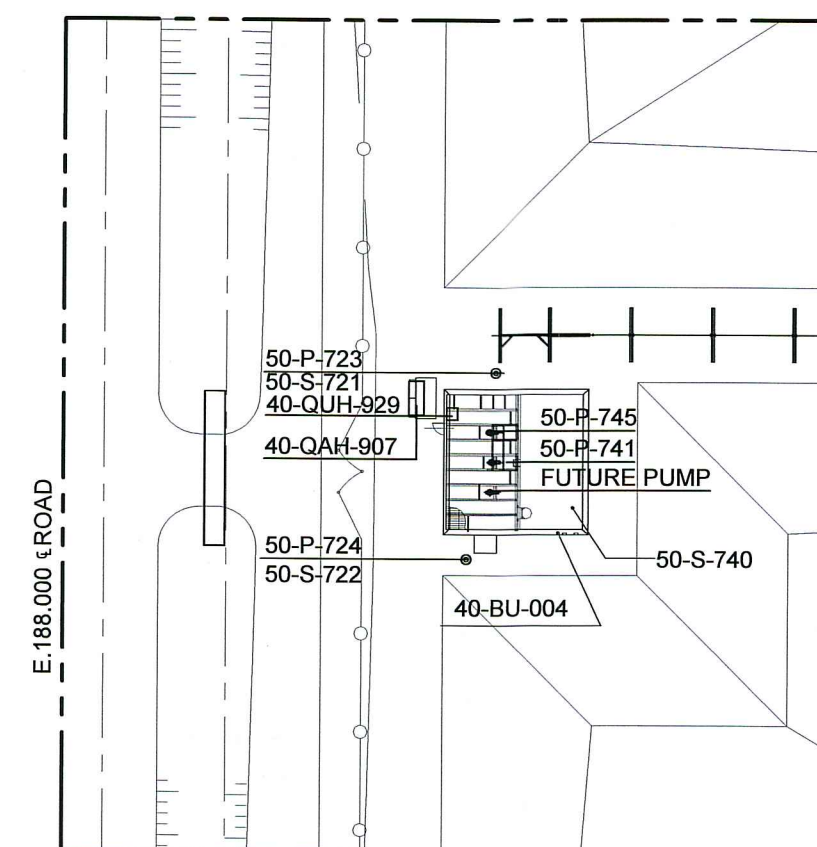

DETAIL
40-BU-004 SCALE 1:500
SNRS-01-96-P-SJ-00002-1

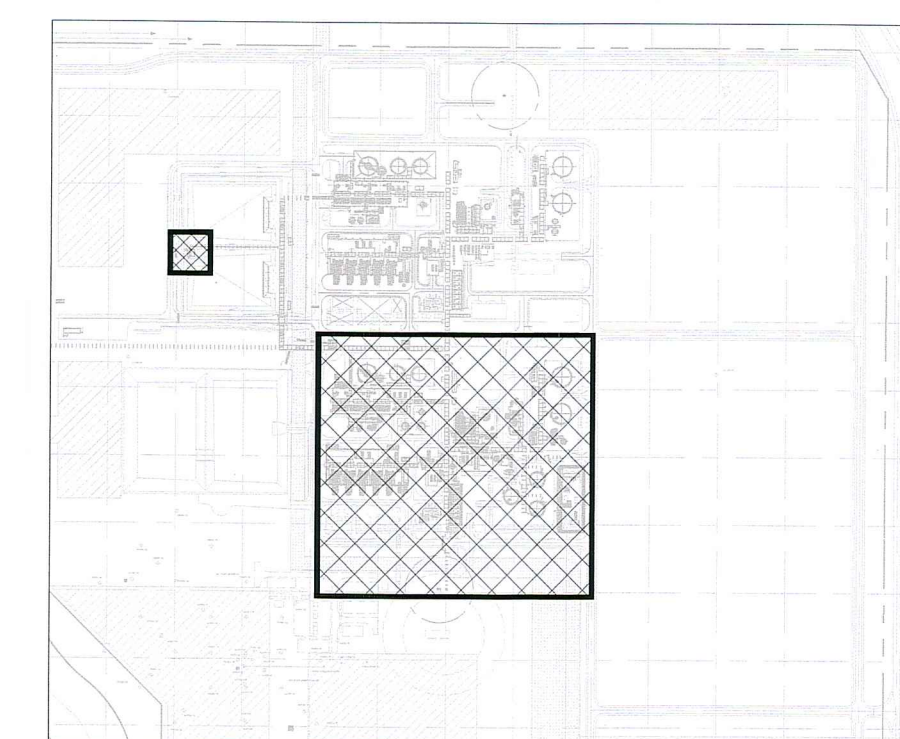


AREA KEY PLAN
SCALE 1:10000



snamprogetti canada

ENGINEERING COMPANY PERMIT STAMP

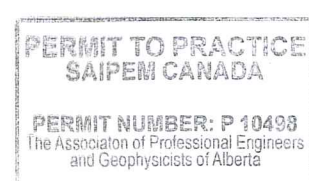

REGISTERED PROFESSIONAL ENGINEER STAMP



REF	DWG NO	REFERENCE DRAWING DESCRIPTION	NO	REV DATE	REVISION HISTORY	ISSUED FOR	BY	CHK	ENG	APR
6	15-01-30	ISSUED FOR AS BUILT	AS BUILT	CS	CZ	MS	EB			
1F	13-03-04	RE-ISSUED FOR CONSTRUCTION	CONSTRUCTION	CC	MB	AS	EA			
1E	12-11-13	RE-ISSUED FOR CONSTRUCTION	CONSTRUCTION	VS	MB	AS	EA			
1D	12-04-16	ISSUED FOR CONSTRUCTION	CONSTRUCTION	VS	MB	AS	LP			
1C	11-10-07	RE-ISSUED FOR REVIEW	REVIEW	AJ	MB	MME	ASA			
1B	11-03-28	RE-ISSUED FOR REVIEW	REVIEW	AJ	MB	RCA	ASA			
1A	11-01-15	ISSUED FOR REVIEW	REVIEW	PF	SV	RCA	ASA			
NO			ISSUED FOR	BY	CHK	ENG	APR			

SPCAN JOB NO H03747

PROJECT NO SR-071

ISSUED FOR AS BUILT

DOC DATE 30-01-2015

DOC AUTHOR C.SHEN

SCALE 1:1000

ALTERNATE IDENTIFIER 96-GB-B-62004

SURFACE L&D 4-15-95-07 W4M

DOCUMENT IDENTIFIER SNRS-01-96-P-PP-00006-1