


AB BT 0089133 -344
HUSKY 12-28-064-04W4
HUSKY TUCKER LAKE 12-28 BITUMEN MWB
344-IN SITU OIL SANDS BATTERY
LICENSEE: HUSKY OIL OPERATIONS LTD
OPERATOR: HUSKY OIL OPERATIONS LTD


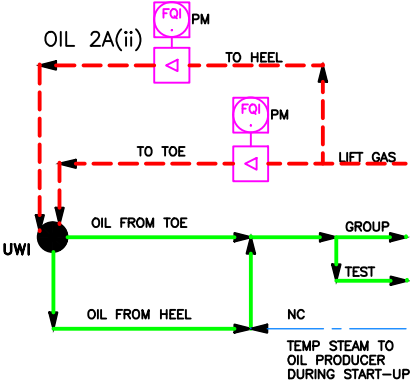


LIFT GAS FROM
MS-0001-03
12-28-064-04W4

WELL PAD D							
WELL NAME	UWI	LSD	LIC/OPER	DETAIL	STATUS	FUEL	LIFT
D24P	111/07-28-064-04W4/00	07-28-064-04W4	HUSKY	OIL 2A(ii)	SAGD	E	ESP
D25P	112/07-28-064-04W4/00	07-28-064-04W4	HUSKY	OIL 2A(ii)	SAGD	E	ESP
D26P	113/07-28-064-04W4/00	07-28-064-04W4	HUSKY	OIL 2A(ii)	SAGD	E	ESP
D27P	114/07-28-064-04W4/00	07-28-064-04W4	HUSKY	OIL 2A(ii)	SAGD	E	ESP
D28P	115/07-28-064-04W4/00	07-28-064-04W4	HUSKY	OIL 2A(ii)	SAGD	E	ESP
D29P	116/07-28-064-04W4/00	07-28-064-04W4	HUSKY	OIL 2A(ii)	SAGD	E	ESP
D30P	104/02-28-064-04W4/00	02-28-064-04W4	HUSKY	OIL 2A(ii)	SAGD	E	ESP
D31P	105/02-28-064-04W4/00	02-28-064-04W4	HUSKY	OIL 2A(ii)	SAGD	E	ESP
D32P	106/02-28-064-04W4/00	02-28-064-04W4	HUSKY	OIL 2A(ii)	SAGD	E	ESP
D33P	107/02-28-064-04W4/00	02-28-064-04W4	HUSKY	OIL 2A(ii)	SAGD	E	ESP

WELL PAD D							
WELL NAME	UWI	LSD	LIC/OPER	DETAIL	STATUS	FUEL	LIFT
D34P	112/02-28-064-04W4/00	02-28-064-04W4	HUSKY	OIL 2A(ii)	SAGD	E	ESP
D35P	111/02-28-064-04W4/00	02-28-064-04W4	HUSKY	OIL 2A(ii)	SAGD	E	ESP
D36P	115/02-28-064-04W4/00	02-28-064-04W4	HUSKY	OIL 2A(ii)	SAGD	E	ESP
D37P	108/02-28-064-04W4/00	02-28-064-04W4	HUSKY	OIL 2A(ii)	SAGD	E	ESP
D38P	109/02-28-064-04W4/00	02-28-064-04W4	HUSKY	OIL 2A(ii)	SAGD	E	ESP
D1P	104/04-29-064-04W4/00	04-29-064-04W4	HUSKY	OIL 2A(ii)	SAGD	E	ESP
D2P	114/04-29-064-04W4/00	04-29-064-04W4	HUSKY	OIL 2A(ii)	SAGD	E	ESP
D3P	102/04-29-064-04W4/00	04-29-064-04W4	HUSKY	OIL 2A(ii)	SAGD	E	ESP
D4P	106/04-29-064-04W4/00	04-29-064-04W4	HUSKY	OIL 2A(ii)	SAGD	E	ESP
D5P	108/04-29-064-04W4/00	04-29-064-04W4	HUSKY	OIL 2A(ii)	SAGD	E	ESP

WELL PAD D							
WELL NAME	UWI	LSD	LIC/OPER	DETAIL	STATUS	FUEL	LIFT
D16P	104/16-29-064-04W4/00	08-29-064-04W4	HUSKY	OIL 2A(ii)	SAGD	E	ESP
D17P	105/16-29-064-04W4/00	08-29-064-04W4	HUSKY	OIL 2A(ii)	SAGD	E	ESP
D18P	107/16-29-064-04W4/00	08-29-064-04W4	HUSKY	OIL 2A(ii)	SAGD	E	ESP
D19P	109/16-29-064-04W4/00	08-29-064-04W4	HUSKY	OIL 2A(ii)	SAGD	E	ESP
D20P	111/16-29-064-04W4/00	08-29-064-04W4	HUSKY	OIL 2A(ii)	SAGD	E	ESP
D21P	113/16-29-064-04W4/00	08-29-064-04W4	HUSKY	OIL 2A(ii)	SAGD	E	ESP
D22P	115/16-29-064-04W4/00	08-29-064-04W4	HUSKY	OIL 2A(ii)	SAGD	E	ESP
D23P	117/16-29-064-04W4/00	08-29-064-04W4	HUSKY	OIL 2A(ii)	SAGD	E	ESP

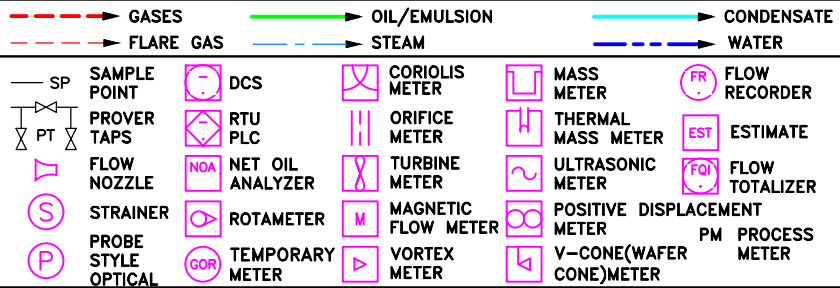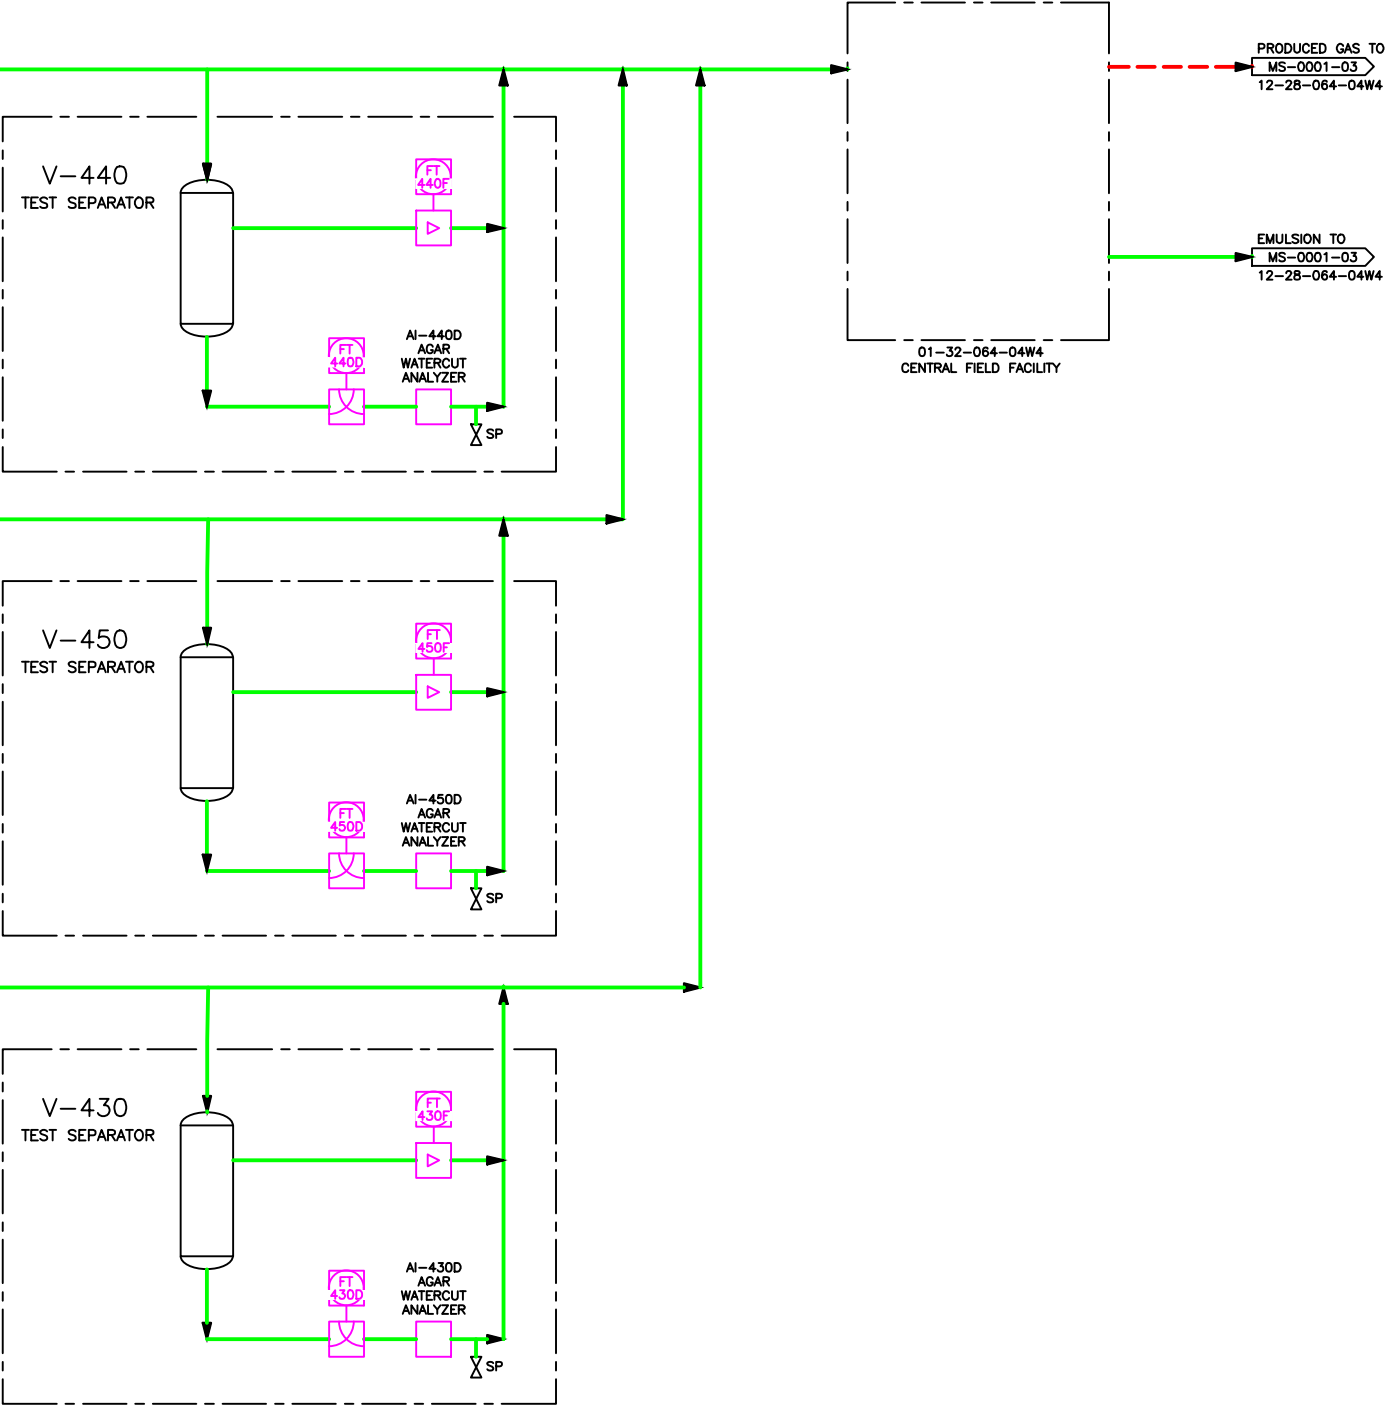

REF DWG NO	REFERENCE DRAWING DESCRIPTION	NO	REVISION HISTORY	REV AUTHOR	REV DATE	ISSUED FOR	NO	CURRENT REVISION	ISSUED FOR AS BUILT
MS-0000-01	AREA OVERVIEW	8	UPDATED PER MARK UPS FROM ALLYSON HADLAND	SK	2016/02/24	AS BUILT	11	UPDATED FROM MARK UPS FROM ELSIE GUERRA	DOC DATE 2018/03/20
MS-0001-03 & 04	FACILITY DRAWING	9	NO UPDATES FOR THIS REVISION FROM ALLYSON HADLAND	PC	2016/08/12	AS BUILT			DOC AUTHOR SK
MS-0002-01 TO 03,05 TO 07	WELLS/FIELD	10	UPDATED FROM MARK UPS FROM ALLYSON HADLAND	SK	2017/01/19	AS BUILT			SCALE NTS
MS-0007-01 TO 03	STEAM INJECTION SYSTEM	4	UPDATED FROM MARK UPS SUPPLIED BY ALLYSON HADLAND	BRM	2015/02/24	AS BUILT			ALTERNATE IDENTIFIER
MS-0004-01	WATER DISPOSAL SYSTEM	5	UPDATED FROM MARK UPS SUPPLIED BY PETE CURRAN	BRM	2015/07/06	AS BUILT			
MS-0010-01	LACT UNIT	6	UPDATED FROM MARK UPS SUPPLIED BY PETE CURRAN	BRM	2015/07/27	AS BUILT			
		7	NO UPDATES FOR THIS REVISION FROM ALLYSON HADLAND	BRM	2015/10/29	AS BUILT			

Husky Oil Operations Limited
TUCKER CENTRAL PLANT 12-28-064-04W4
D PADS EAST AND NORTH
WELLS/FIELD
MEASUREMENT SCHEMATIC

SURFACE LSD 12-28-064-04W4	DOCUMENT IDENTIFIER MS-0002-04
----------------------------	--------------------------------

CAD DRAWING: DO NOT CHANGE MANUALLY